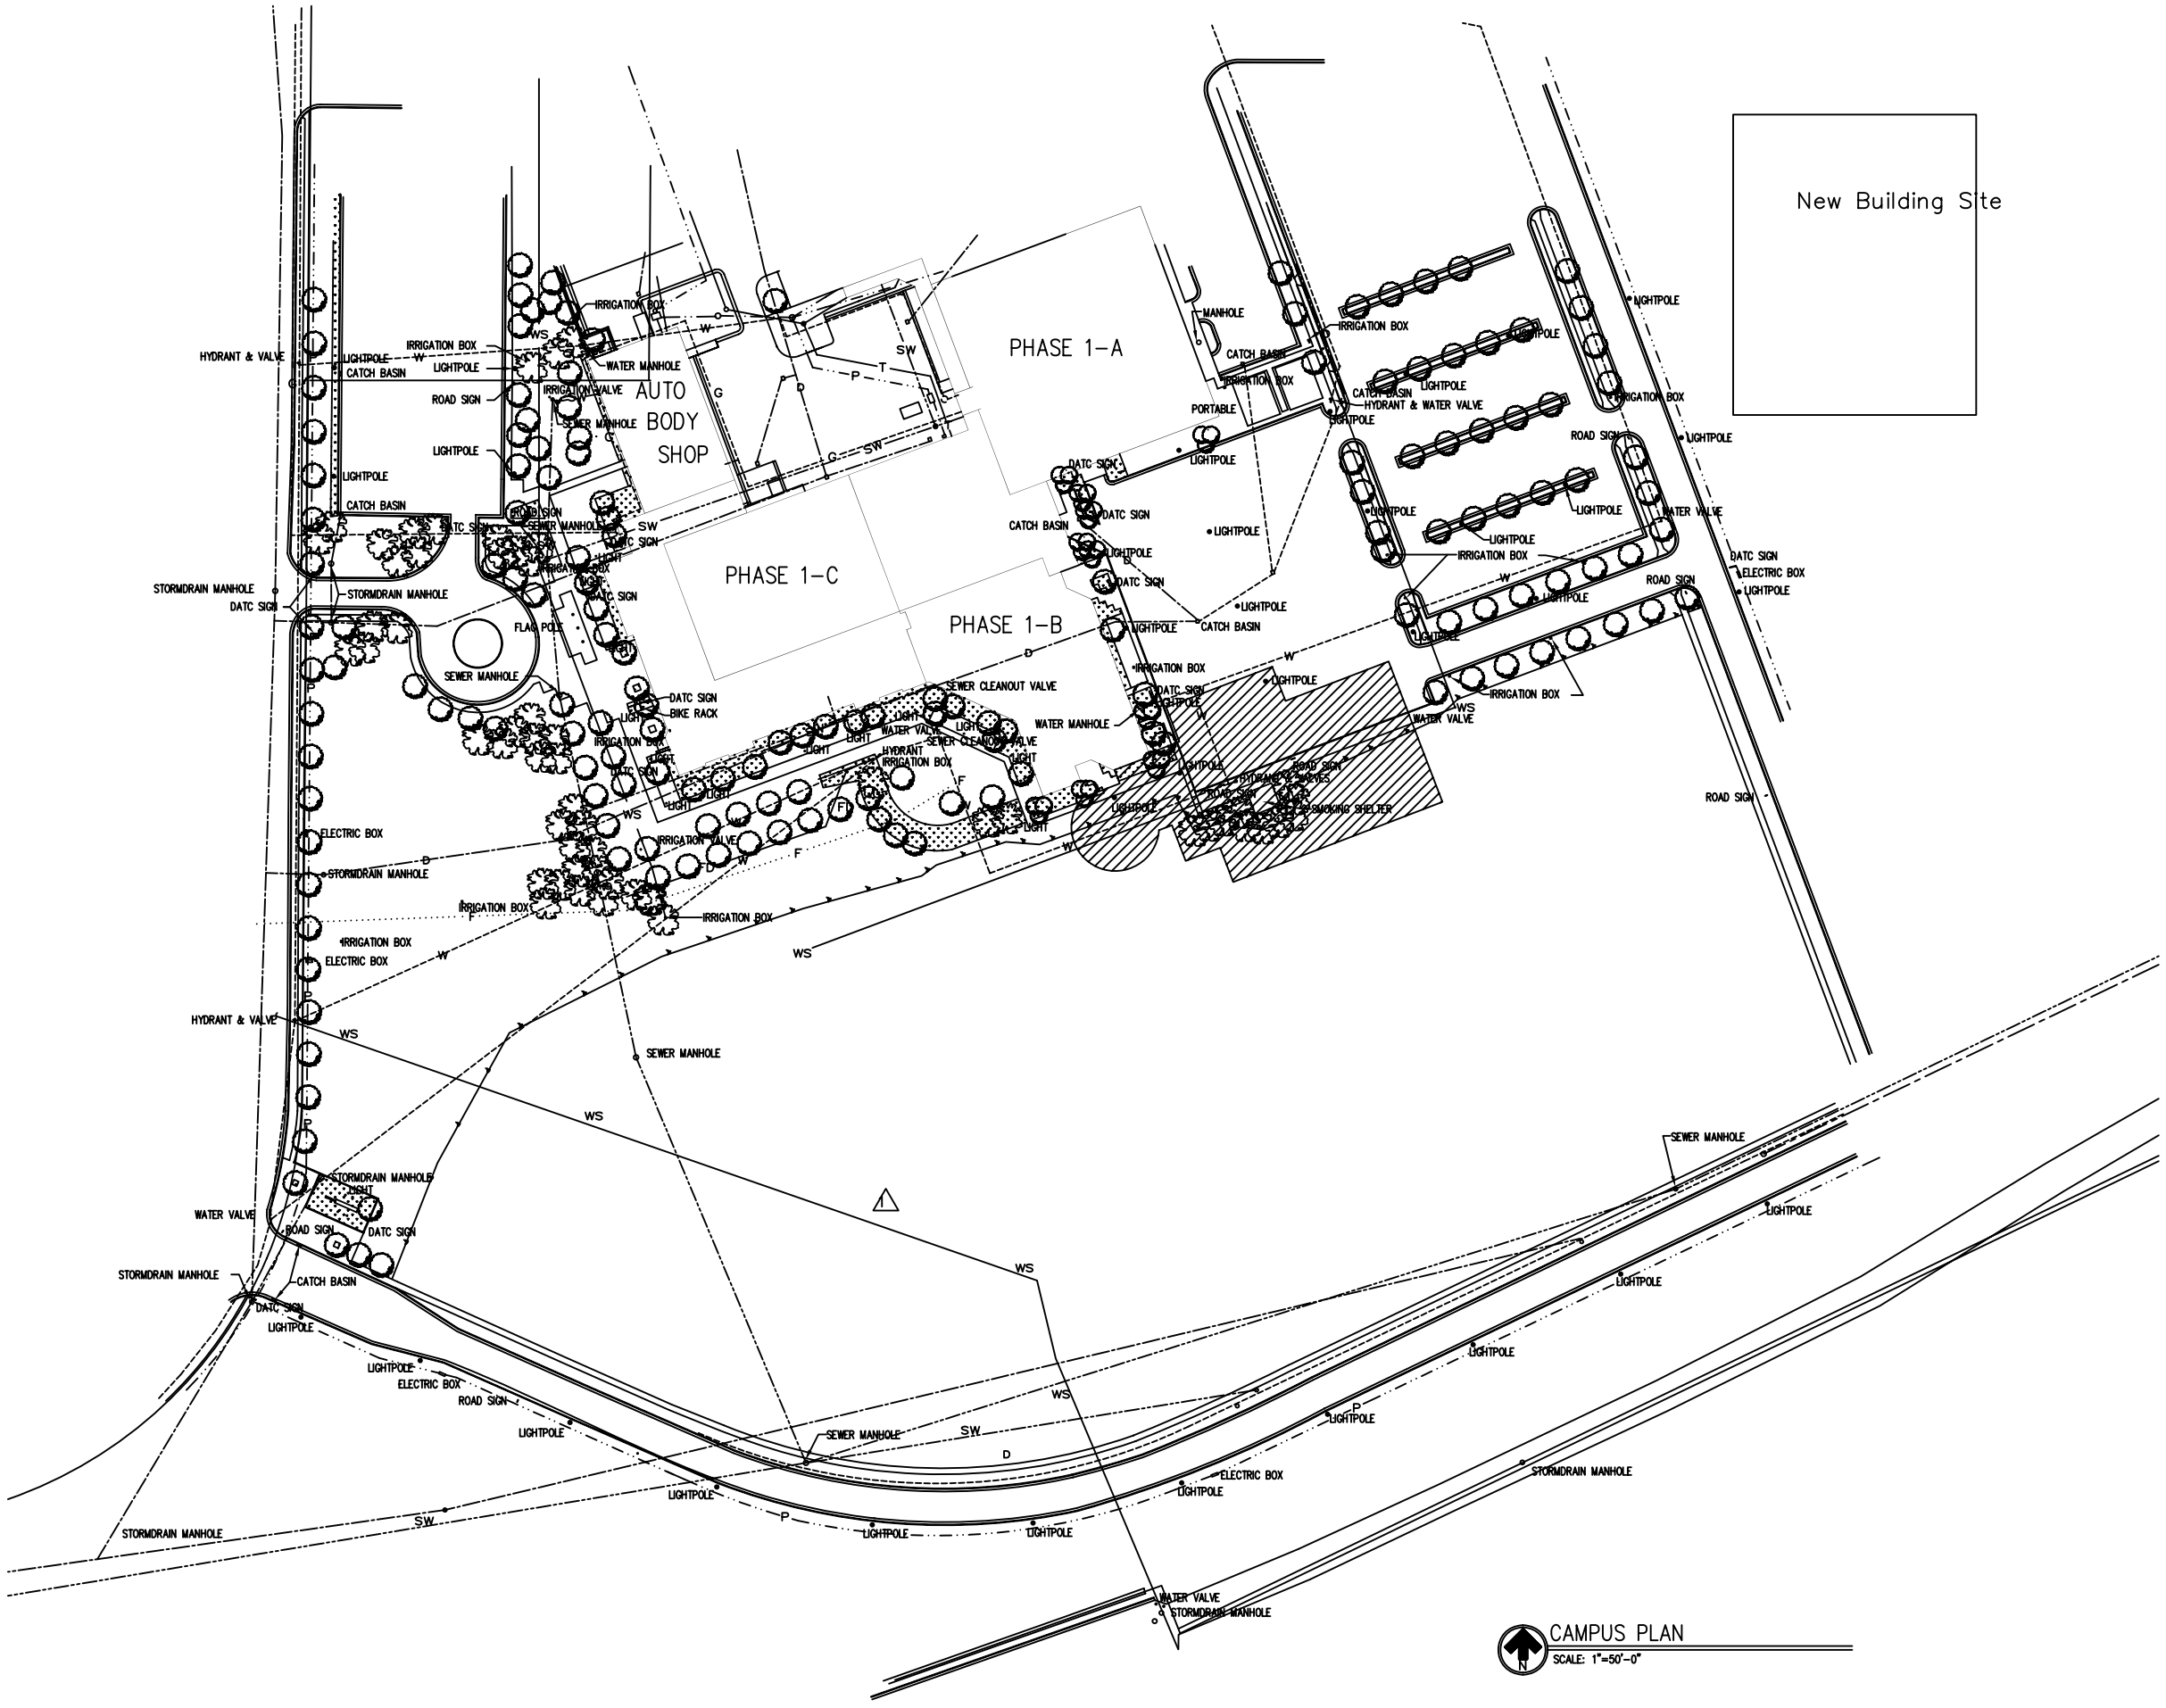

CAMPUS PLAN

SCALE: 1"=50'-0"

HART FISHER SMITH & ASSOCIATES

ARCHITECTURE, PROGRAMMING, PLANNING

The Judge Building, Suite 410
8 East Broadway
Salt Lake City, Utah 84111

Telephone 801.596.0691
Facsimile 801.596.0693

MEDICAL/HEALTH TECHNOLOGY ADDITION
DAVIS ATC

Record Drawings

REVISIONS:

CAMPUS PLAN

DATE: January 20, 1999	HFS PROJECT NO: 9612.01
DRAWN BY: WBA	CLIENT PROJECT NO: ED 94042
CHECKED BY: BWS	SHEET NO:

A101

DAVIS APPLIED TECHNOLOGY COLLEGE

Campus Layout & Parking

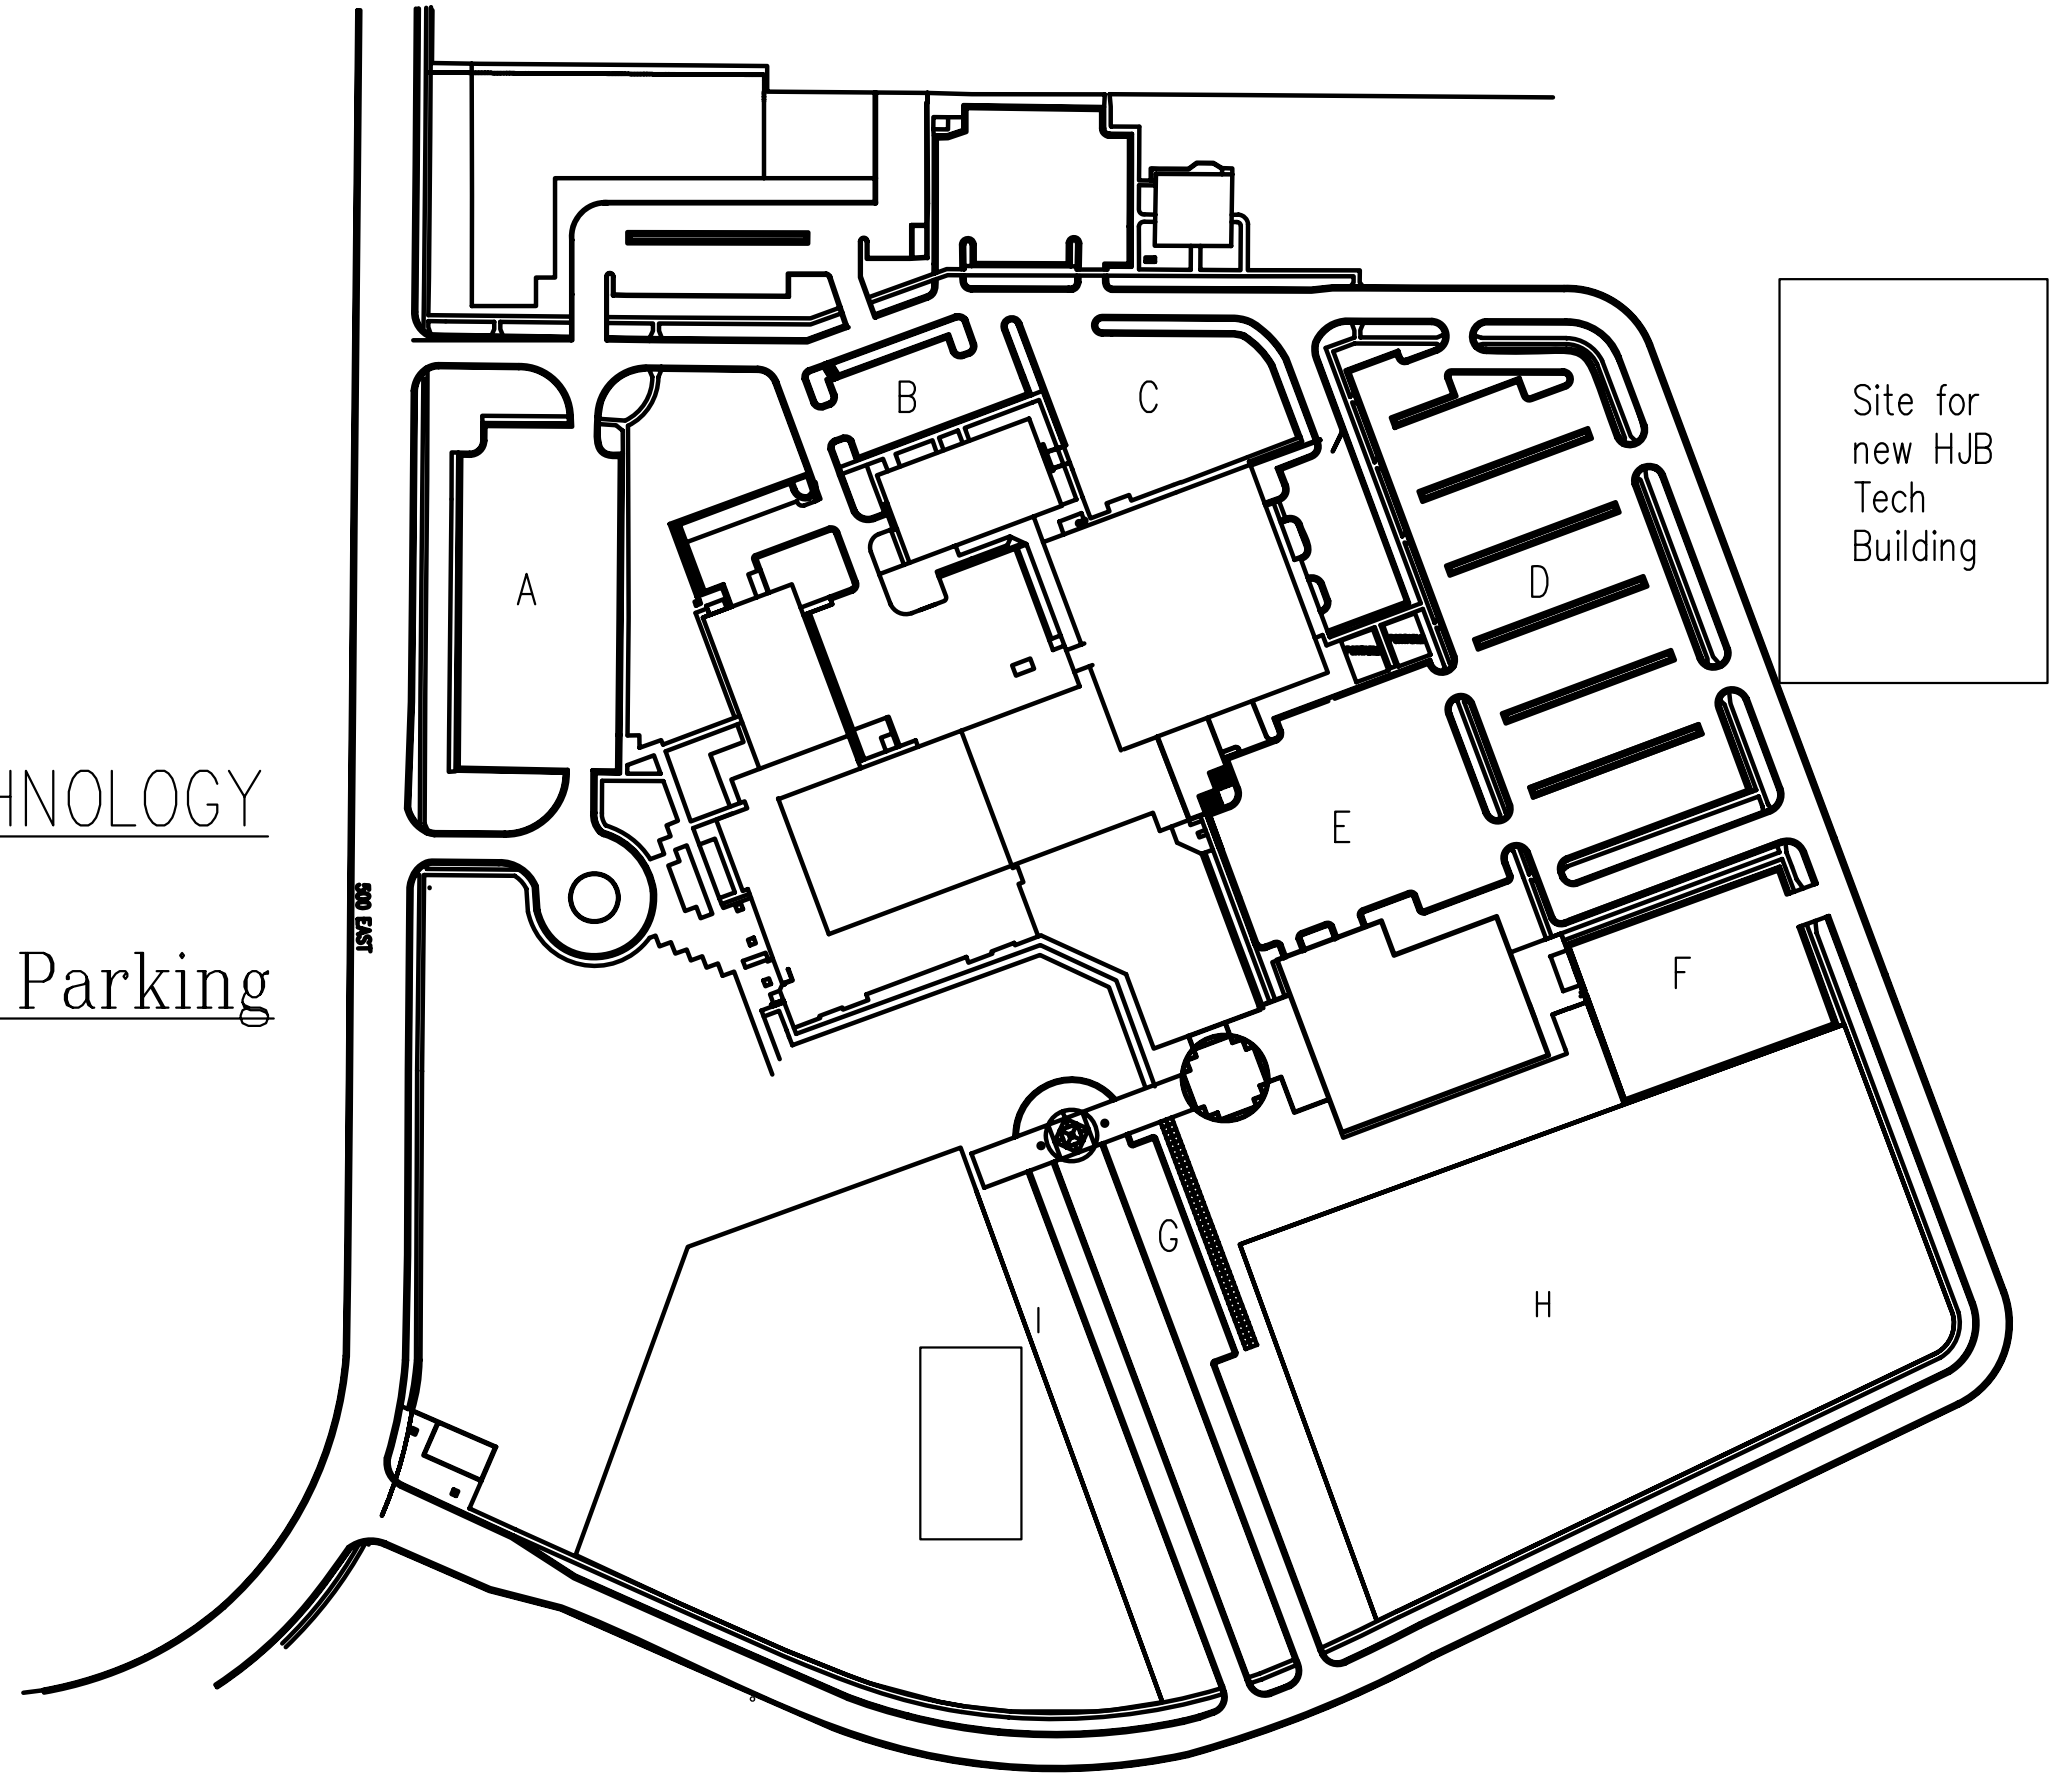

A–
B–
C–
D–
E–
F–
G–
H–
I–
1–
2–
3–
4–
5–
6–