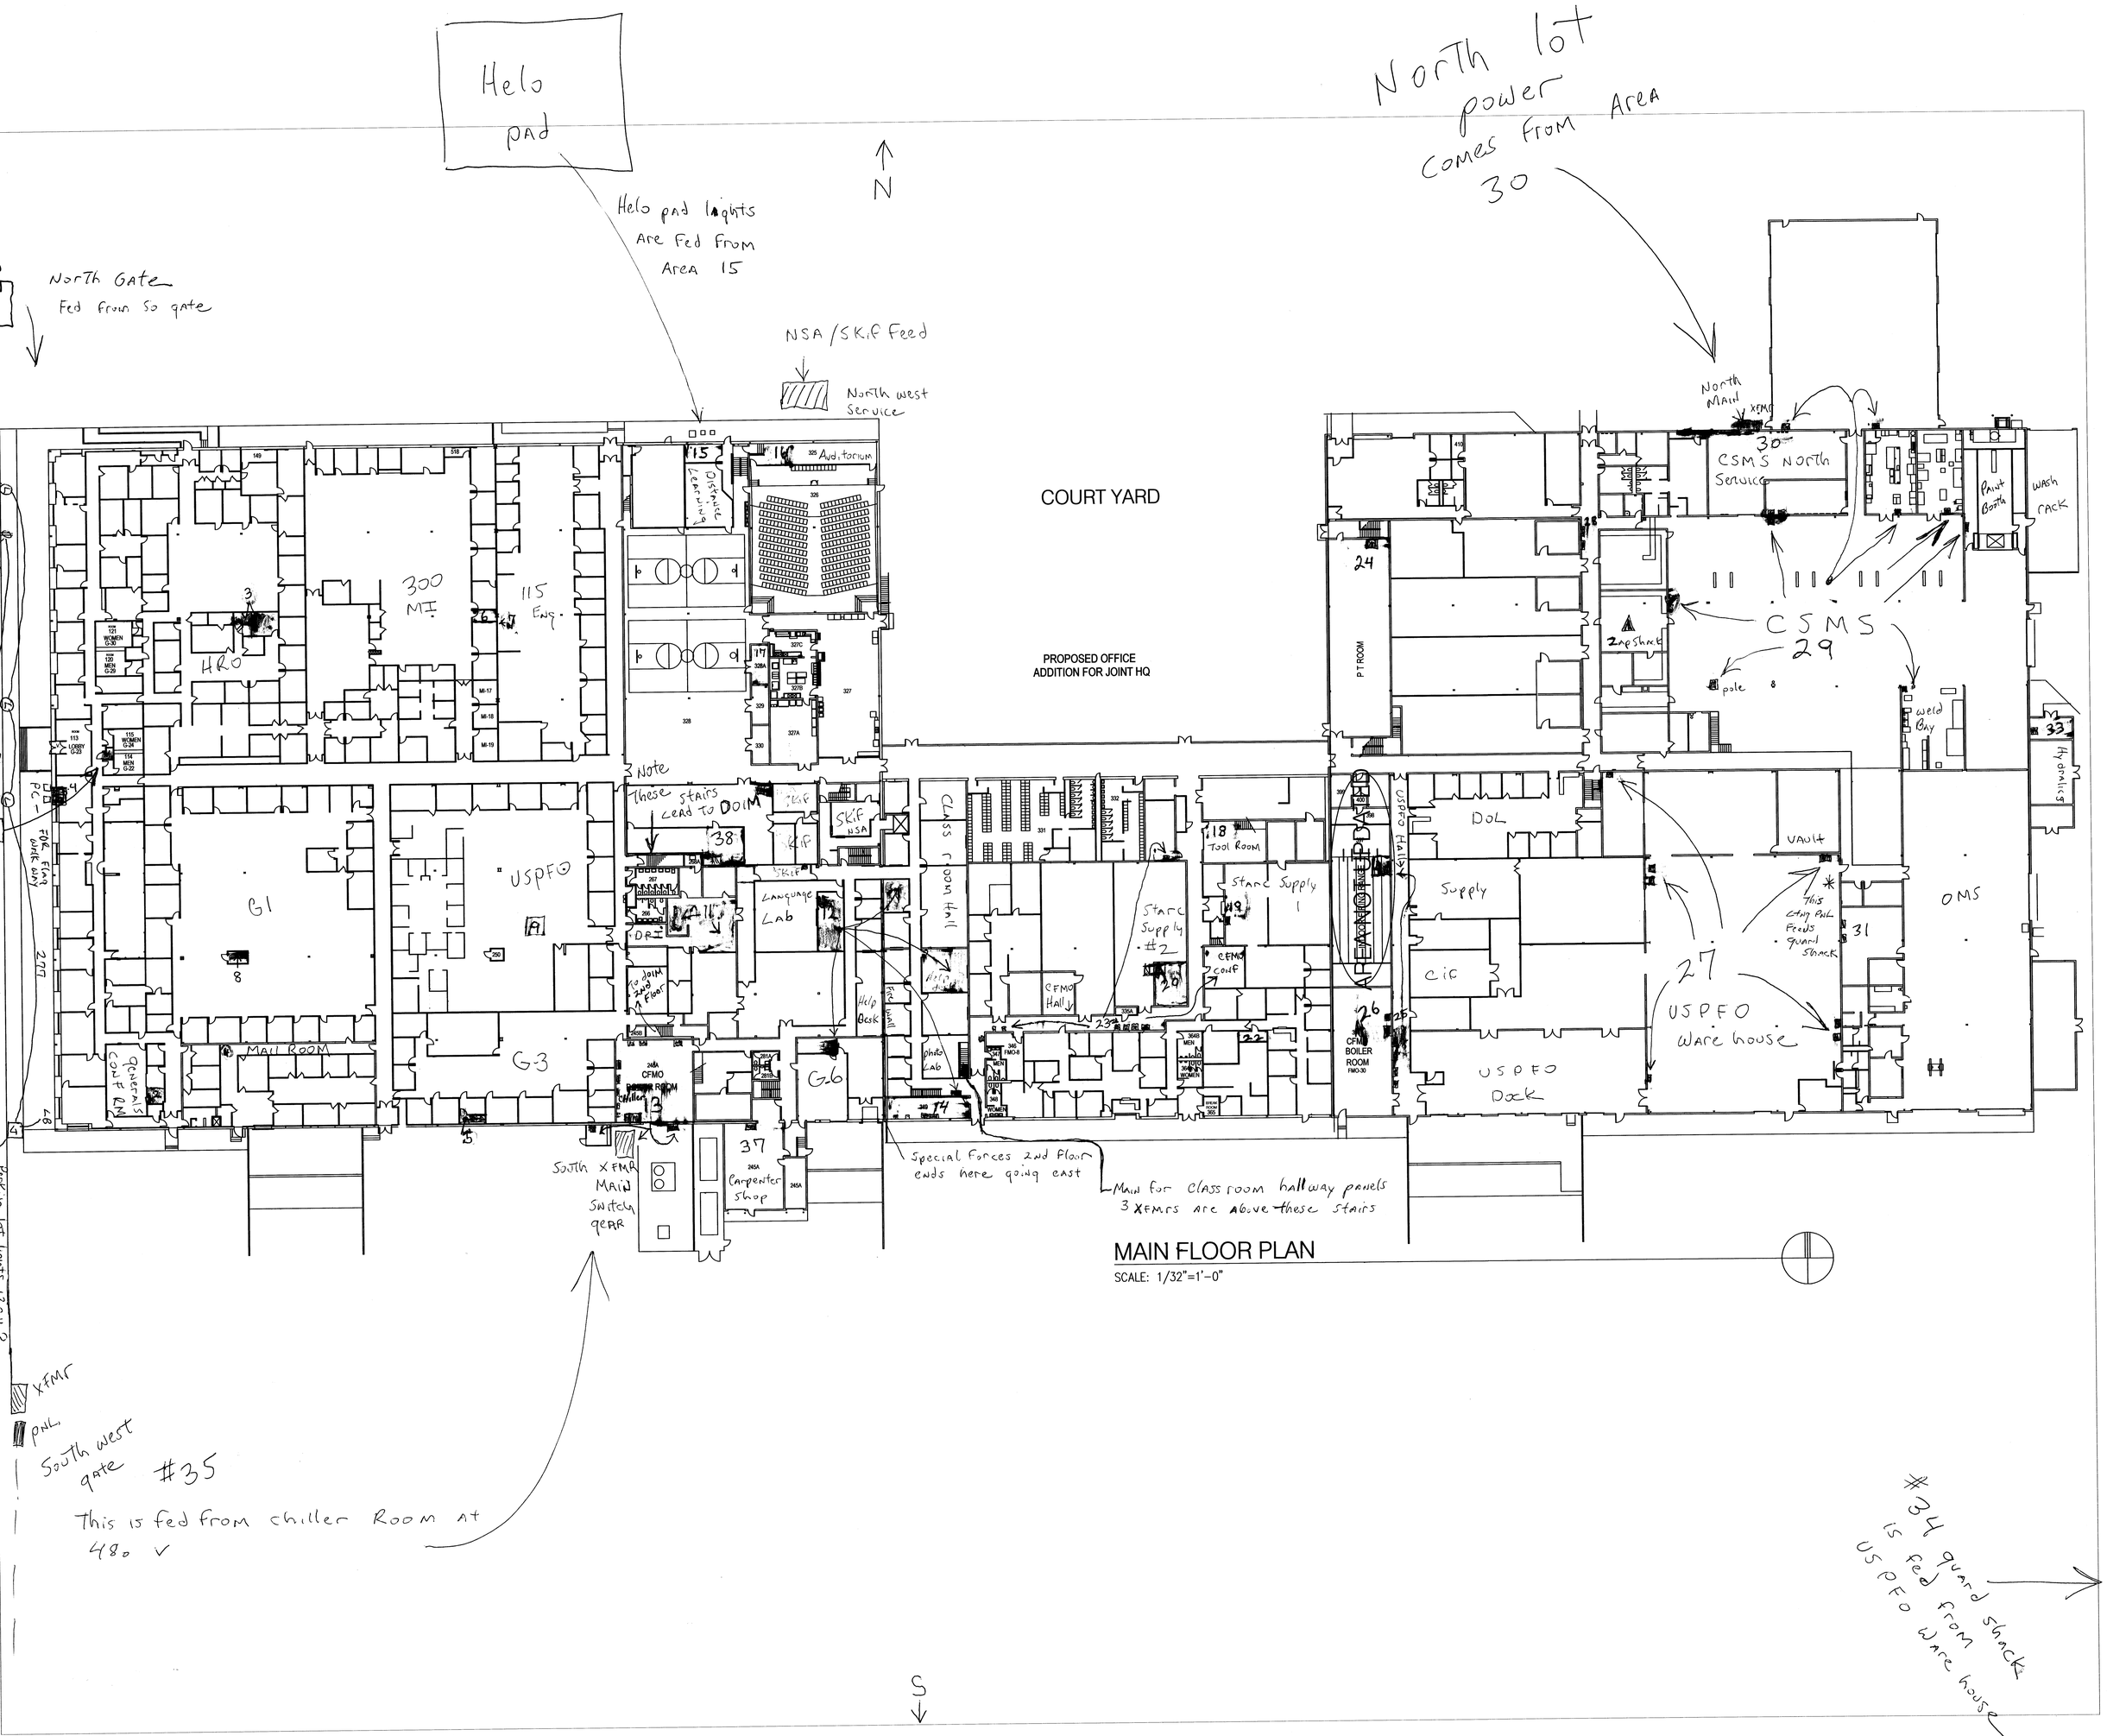

MAIN FLOOR PLAN

SCALE: 1/32"=1'-0"

Note: Floor plan overall is 6 years old

Here is a Listing of Known System and Area power Sources.

1. At Least one of G1 480/277 pnls (#8) is Fed from USPFO #9 480/277 panel USPFO is Fed from chiller RM
2. G-1 modular Furniture and parimeter offices panel Label are correct
3. 300 MI modular Furniture power poles/panel Labels Are Correct
4. NSA/SKIFF panel Label should be correct as they are brand new and are required to be marked - Note; NSA Covers Area above class room hall way to Fire wall marked in Red.
5. Starc Supply #2 (Area 20) should be correct and is Fed From CFMO Hall
6. There are 3 XFMRS above Stairs in photo Lab Area
7. * Any area that is already complete without discrepancy needs to be part of and included on/in any one line diagram and or digital process. . . . This is Vital
8. SKIF/Mezzanine has under gone many recent changes
   A. All SKIF power from So. Service is now unused and dead ended in J Boxes etc. Some SKIF power sources were used for HVAC or NSA issues primarily on Mezzanine
9. There will be many dead ended circuits Tucked in panels or even connected to breakers
10. You will Find many abandoned Conduits, circuits etc.
11. Alot of panel boards are already marked correctly but branch circuits have been routinely tapped into and subsequent outlet not marked
12. Many branch circuits begin with a Fused Switch
13. Have Rachel or Scott create copy of disk for NSA/SKIF remodel 1 and 2
14. There are small panels in zap shack ▲ specific to local work benches which I believe are DC volts ? Fed from Converter Above room
15. Panel in Area #1 feeds All 120 V Front lawn circuits to include flag Lts/Sign
16. A. 277 V bldg/display Lights are P-C Controled outside of chiller RM Source is either chiller or phone Rm
    B. West parking lot Lts are 120 V PC Controlled from chiller Rm
17. A North Lot Lights are DDC Controlled and Fed from CSMS Area 30
    B Wash Racks Lights are P-C Controlled
    C out side door Lights are P-C Controlled
    D All other out side bldg Lights are DDC Controlled

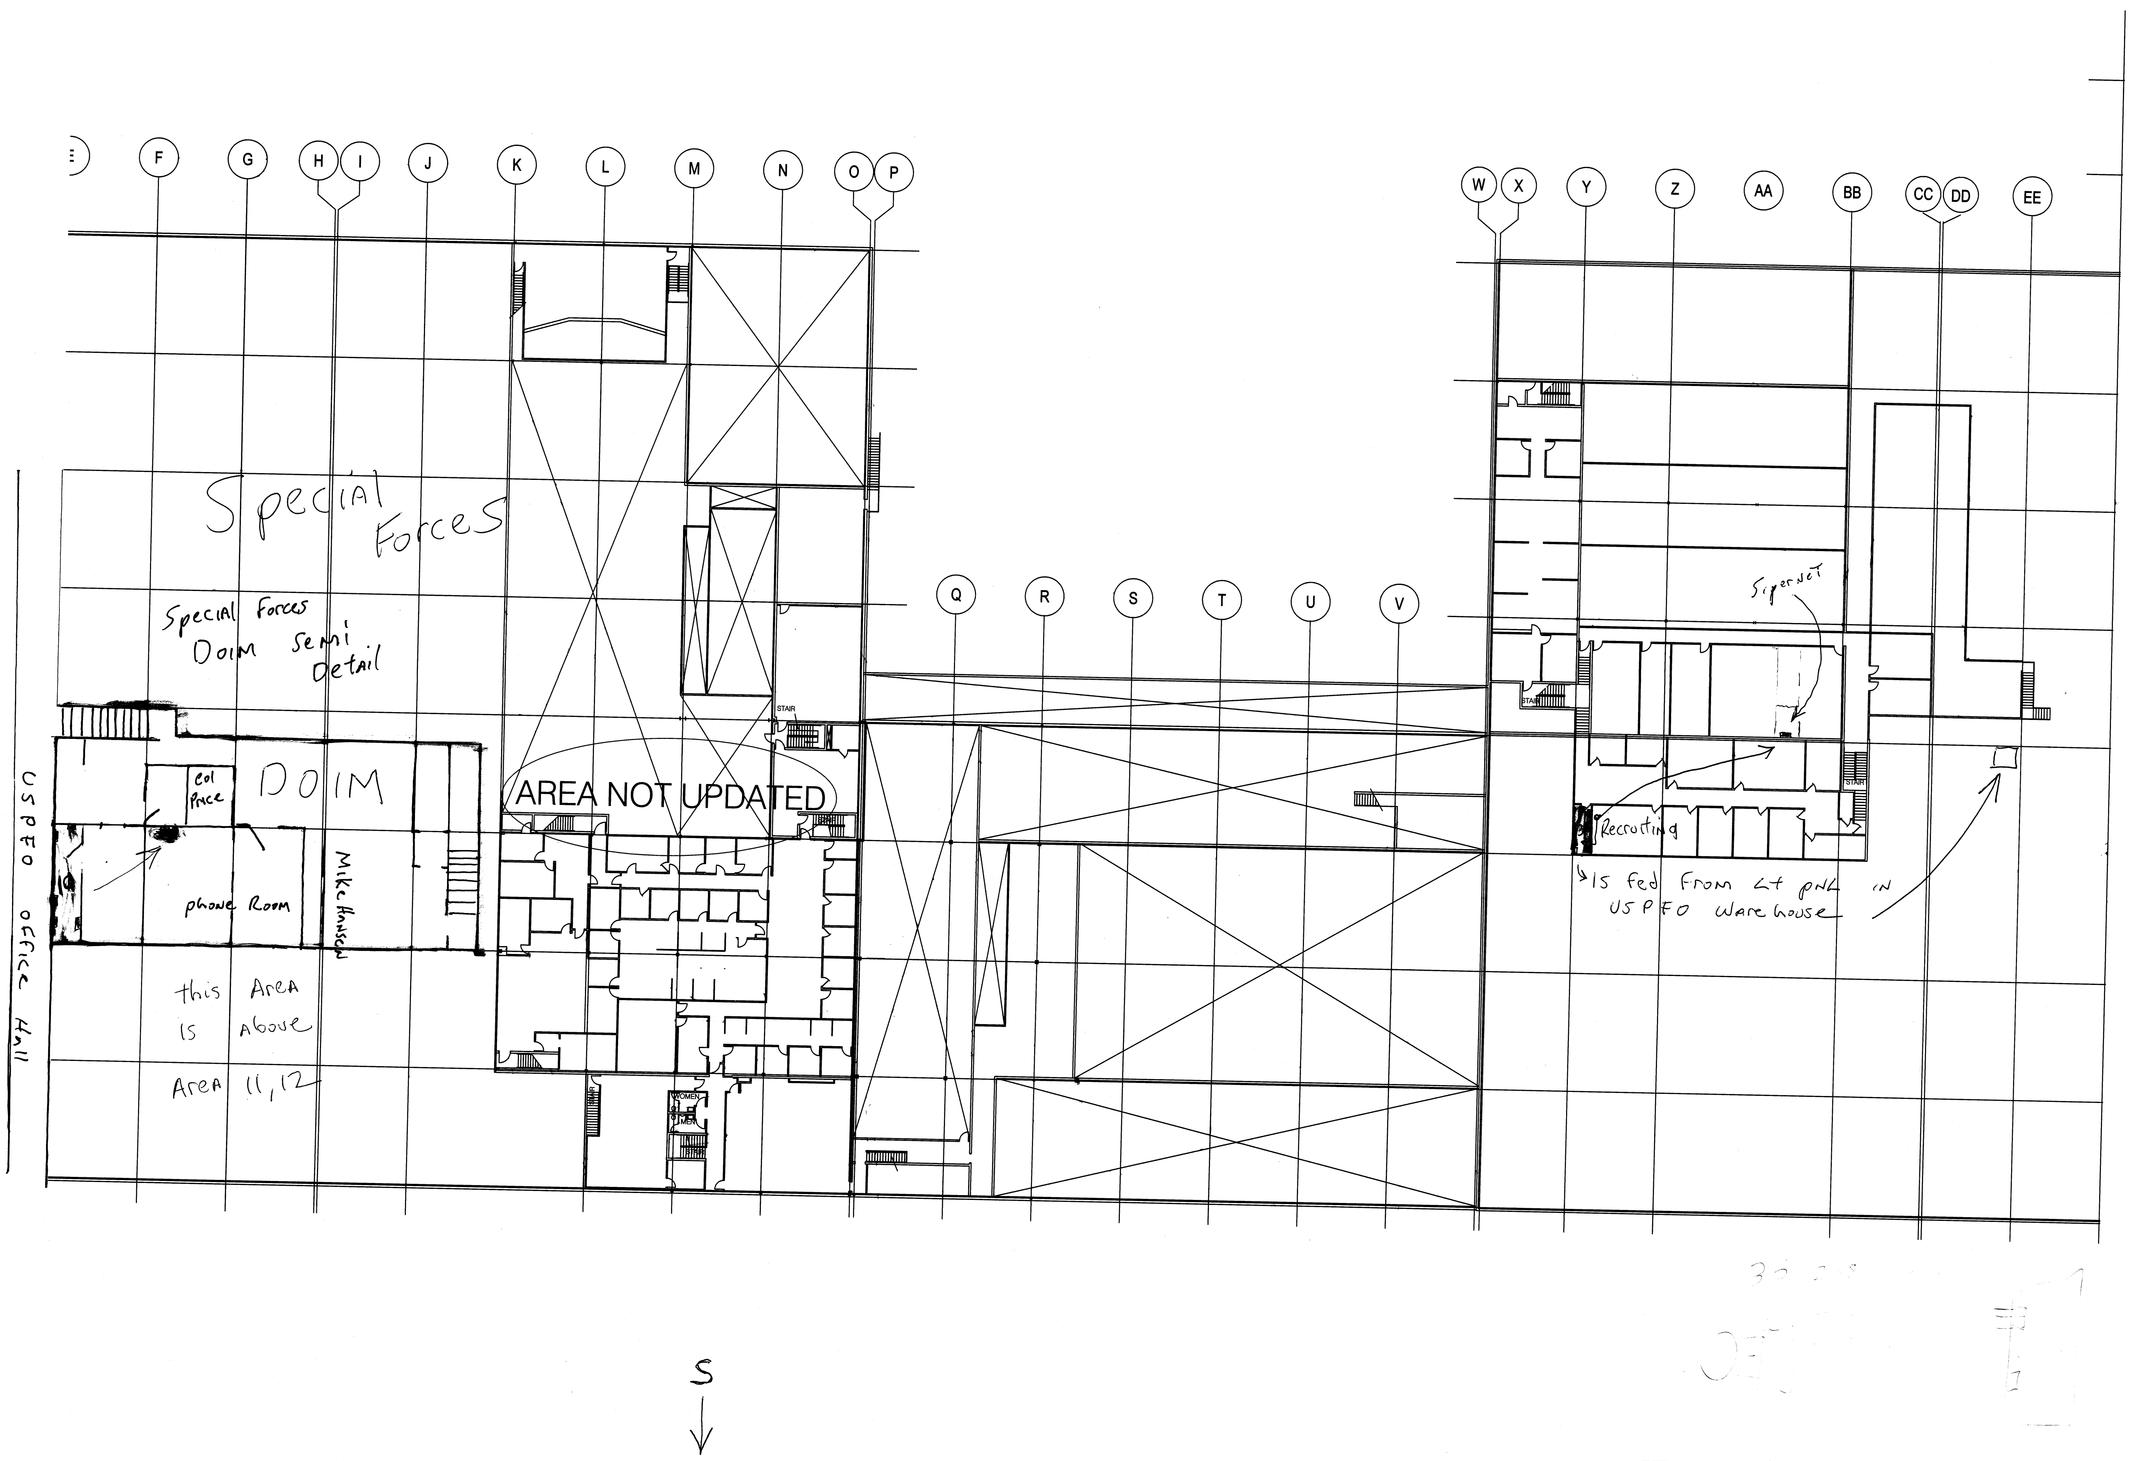

MEZZANINE FLOOR PLAN

SCALE: 1/32"=1'-0"